

West 1654
East 1601.

Original
Corner.

Original
Corner.

Handwritten notes in cursive:

ce or def of...
 ...
 ...
 ...
 ...


JOHN PATE

South 1650

North 2256

North 2015

South 2256

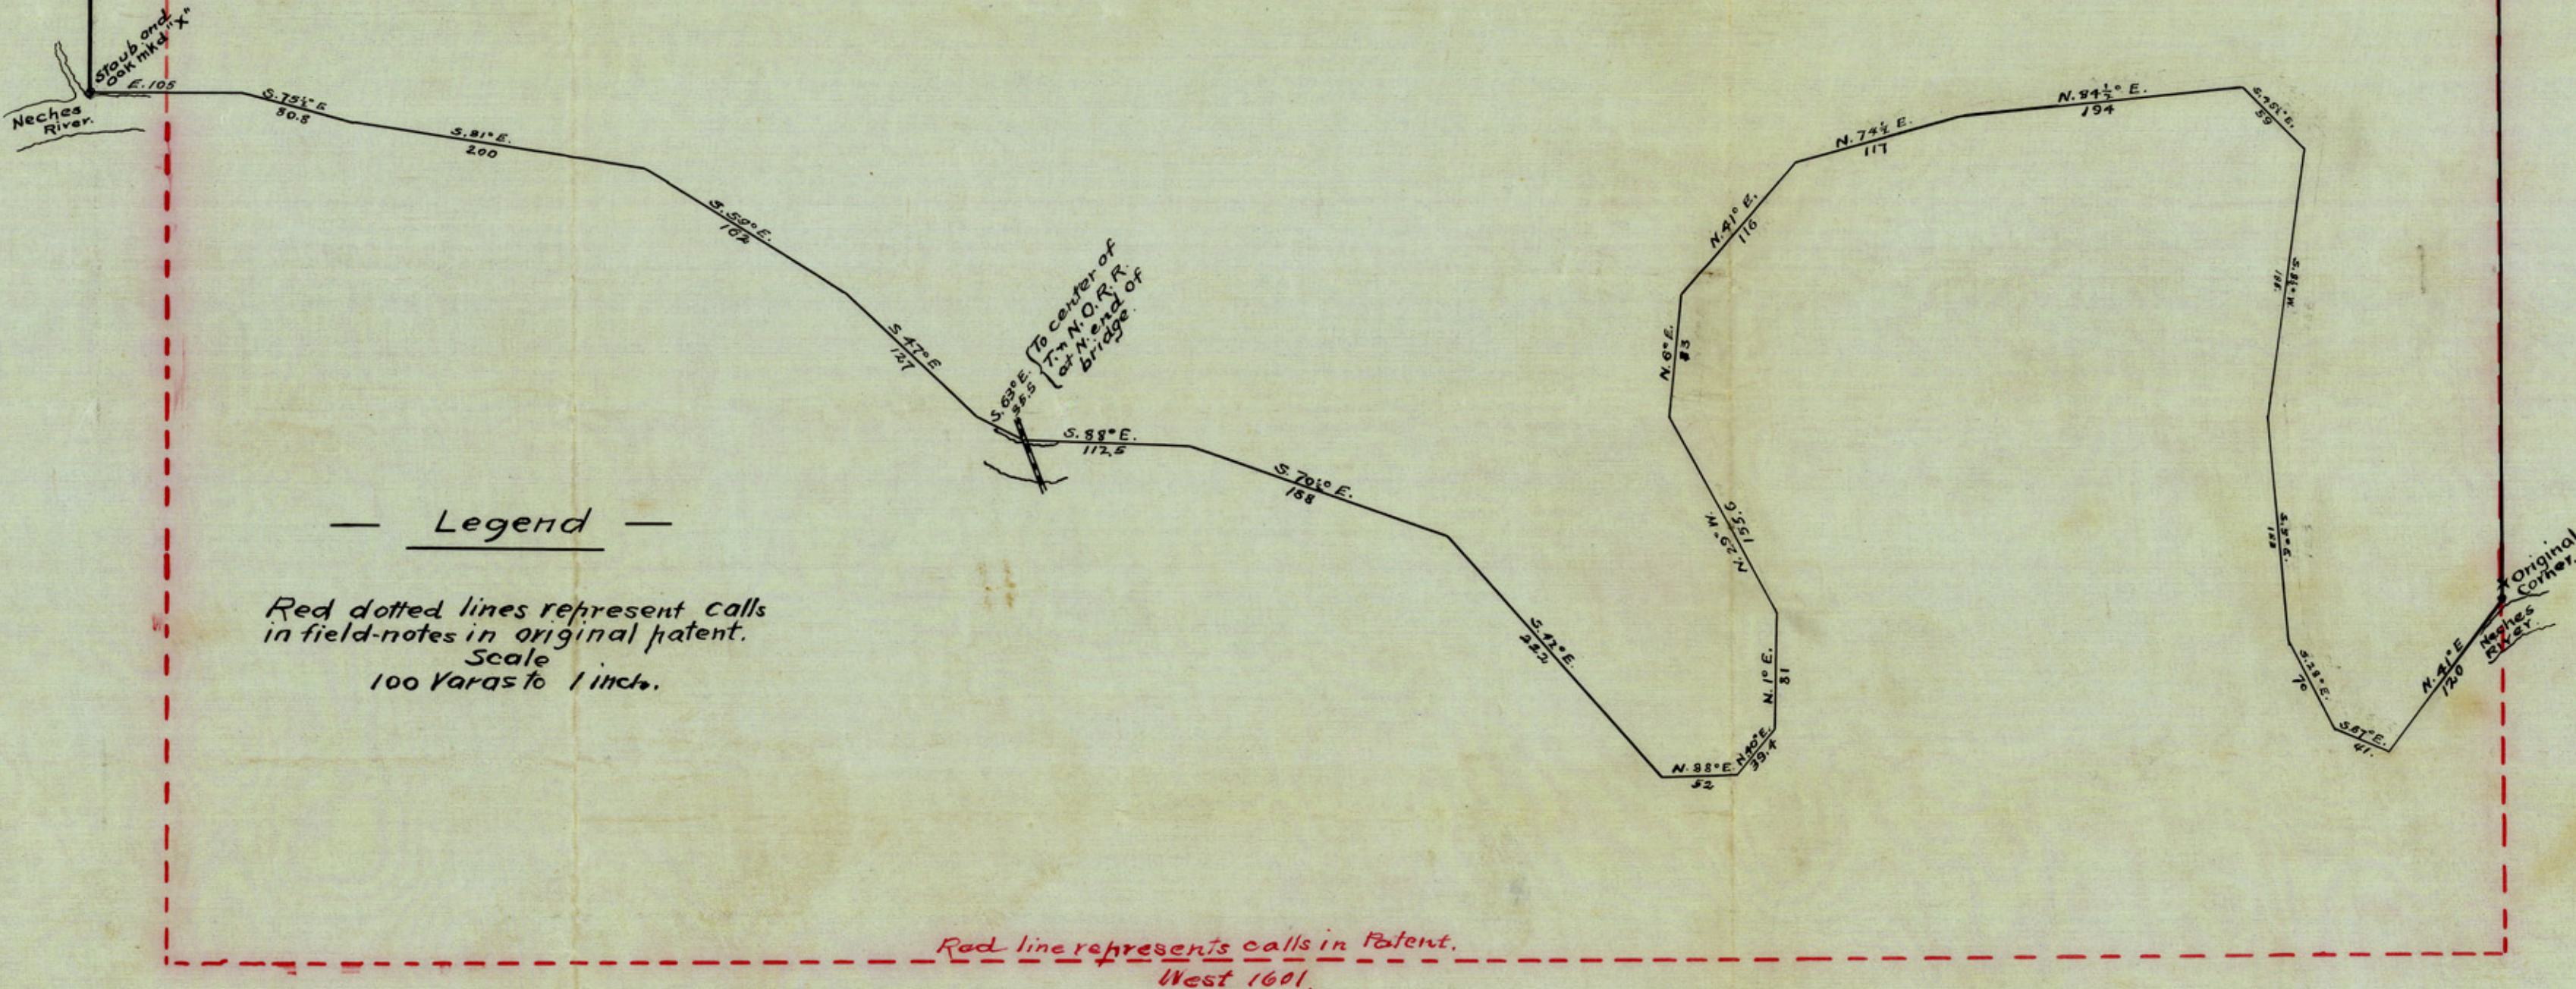

Legend
 Red dotted lines represent calls
 in field-notes in original patent.
 Scale
 100 Varas to 1 inch.

Red line represents calls in Patent.
West 1601.

COMETS # 1653