

BLK. I  
C.H. WHITEHEAD & C.B. WARDLAW  
139573

**BLK. V-II**

14

Set 1" galv. iron pipe in  
Flat, 48 ft. south of  
draw and 85 ft. north  
of caliche road.

NO° 06' 30" E 576.08 vs.  
(North 576.0 vs.)

S 89° 53' 30" E      941.0 vs.  
( East                941.0 vs.)

**BLK. V-9**

129792

# STATE

96.02 Ac.

(West 941.0 vs.)  
N 89° 53' 30" W 941.0 vs.

Set 1" galv. iron pipe  
and built stone mound  
around it, on west  
slope of hill.

**BLK. V-8**

C. H. WHITEHEAD &  
C. B. WARDLAW

139575

## **LEGEND :**

Bearings are true based on a solar observation made at point 12, 1480 ft. westerly of N.W. corner Section 64 1/2, on June 10, 1982.

Distances shown are yards unless otherwise stated

HP 9831A, Tape 4, File III -

Field Book 50 Pages 53-57

M = D

X - Barbed wire fence.

( Record Calls )

T  
S

**Set 1"** galv. iron pipe in center of found old stone mound 15 ft. north of caliche road, one stone marked N.E. 64 1/2 Dod" (R.S.Dod's N.E. corner section 64 1/2).

**BLK. V-12**

**Set 1"** galv. iron pipe in center of found old stone mound, 1 ft. east of fence. Also found "+" mark on large out crop rock North 15.6 ft, large stone mound N 76° 21' W 156.5 ft. (R.S.Dod's patent N.E. corner section 62)

Surveyed - June, 1982

Clinton H. Sumrall  
Clinton H. Sumrall - L.S.L.S.

**PLAT OF SURVEY  
OF  
SECTION 64 1/2  
IN  
EDWARDS COUNTY**

About 23 1/2 miles S 71°W of Rocksprings, Texas

# GENERAL LAND OFFICE - AUSTIN, TEXAS

Scale : 1" = 200 yards

6-15-82 E.L.

BTRK. V-II

W.M.A. PLATMER

44401

S 41 80.000' N 80.000' E 0.000' W 0.000'

SW 1/4  
SW 1/4  
BTRK. V-8

E-T-A-T-E

250.00 ac.

SW 1/4 SW 1/4 SW 1/4 SW 1/4

SW 1/4 SW 1/4 SW 1/4 SW 1/4

N 80.000' W 0.000' E 0.000' S 80.000'

BTRK. V-8

C.H. WHITHEAD &  
C.B. WARDLAW

250.00 ac.

SW 1/4 SW 1/4 SW 1/4 SW 1/4

LEGEND:

ABO II - Measured to NW corner Section 10, Twp 138S.  
Dashed lines show the area subject to water.

HP 3810 Line 4, Tr 111.

Field Book 50, Lot 4, Tr 111.

X = Banded with fence.

(Record Copy)

SK. FILE NO. 55


EDWARDS COUNTY

Section 64 1/2 Blk. V-9

Filed June 16 1982

Bob Armstrong, Com'r

BY J.E. McCarty

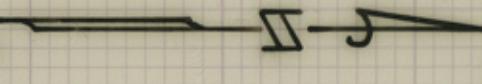

BTRK. V-15

L.C.R.Y. Co.


S-38055

BTRK. V-15

L.C.R.Y. Co.

S-38055

SW 1/4 SW 1/4 SW 1/4 SW 1/4  
SW 1/4 SW 1/4 SW 1/4 SW 1/4  
SW 1/4 SW 1/4 SW 1/4 SW 1/4  
SW 1/4 SW 1/4 SW 1/4 SW 1/4

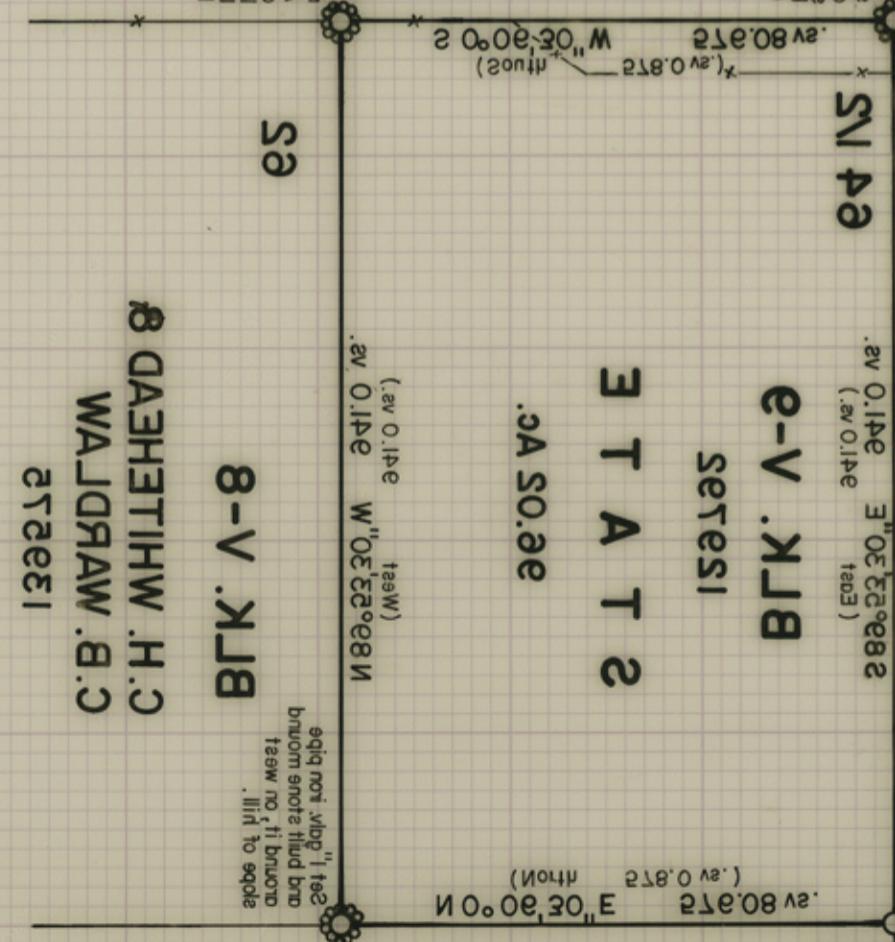

WADRAW B.C. & DAHETHW.H.C

BTRK. I

SW 1/4 SW 1/4 SW 1/4 SW 1/4

SW 1/4 SW 1/4 SW 1/